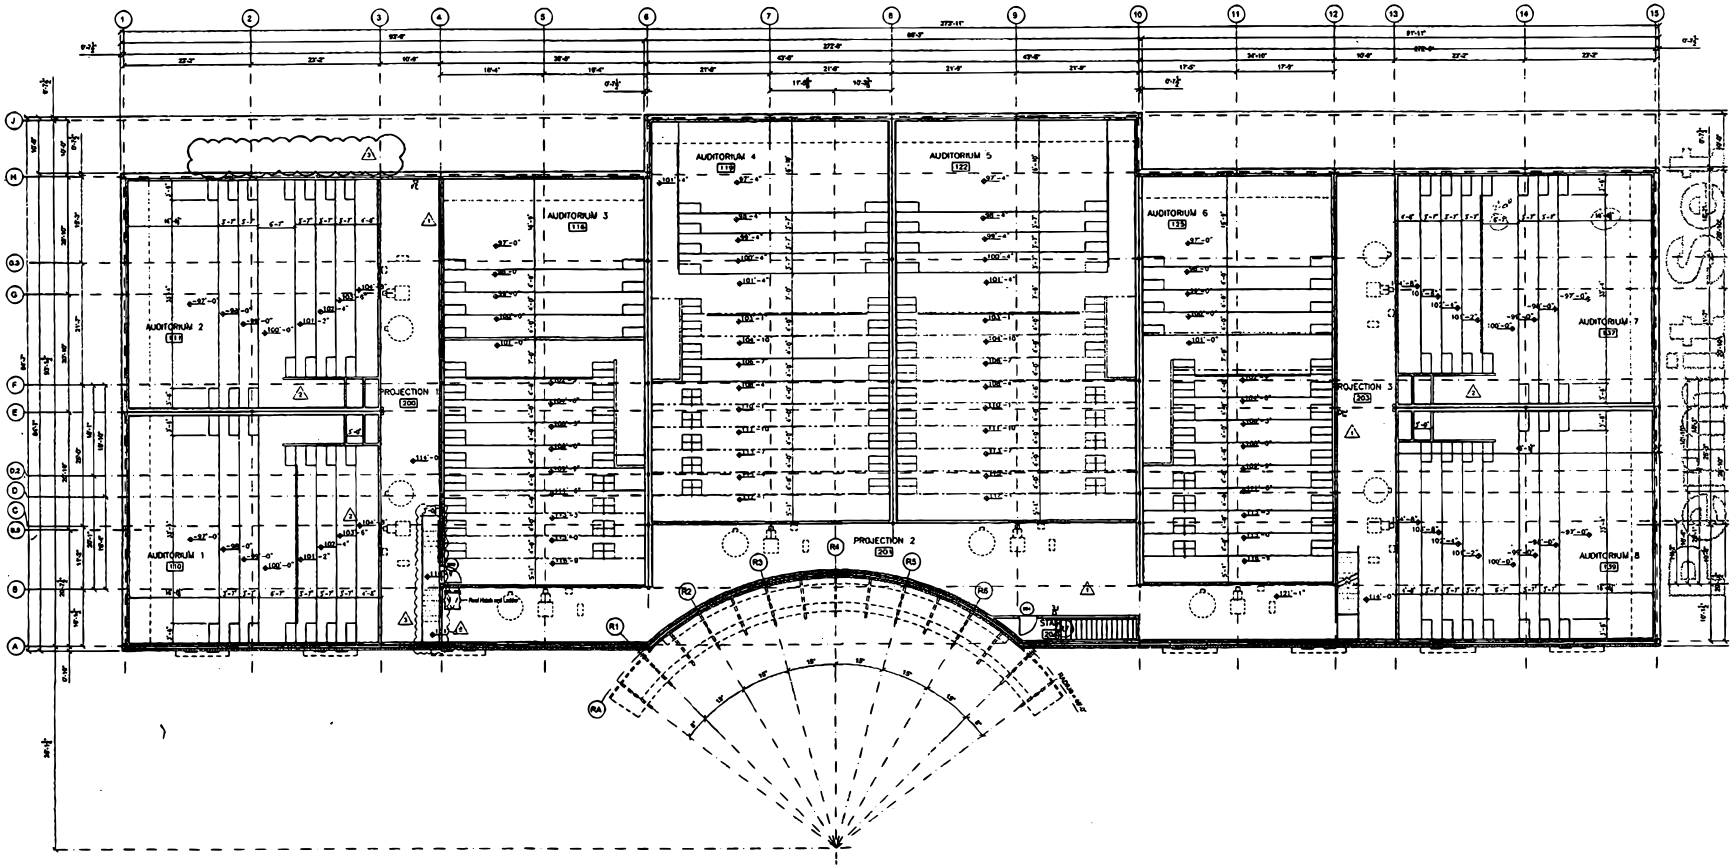

CINEMARK

Owner
Cinemark
3900 Dallas Parkway
Suite 500
Plano, Texas 75093

Structural Engineer
L.A. Fuess Partners Inc.
3400 Carlisle Street
Suite 200
Dallas, Texas 75204
214.871.7010
214.969.0065 fax

M.E.P. Engineer
EnviroDesign, Inc.
900 RR 620 South
Suite C101-301
Austin, Texas 78734
512.692.9015
512.692.9030 fax

PA
PARTNERS IN ARCHITECTURE
5601 WHITEROCK TR., STE. 120
DALLAS, TEXAS 75231
214 349 1274 | fax 214 349 1725
email: mail@partnersinarchitecture.com
http://www.partnersinarchitecture.com

Project: 2312
File: A2.02
Date: 04/12/2004
Scale: 1/8"=1'-0"
Rev. Date:

1 Plan Review Comment
2 Owners Comments
3 08/28/04 City Comment
4
5
6
7
8
9
10
11
12
Seal

Sheet Name
Mezzanine Plan

Sheet Number
A2.02